
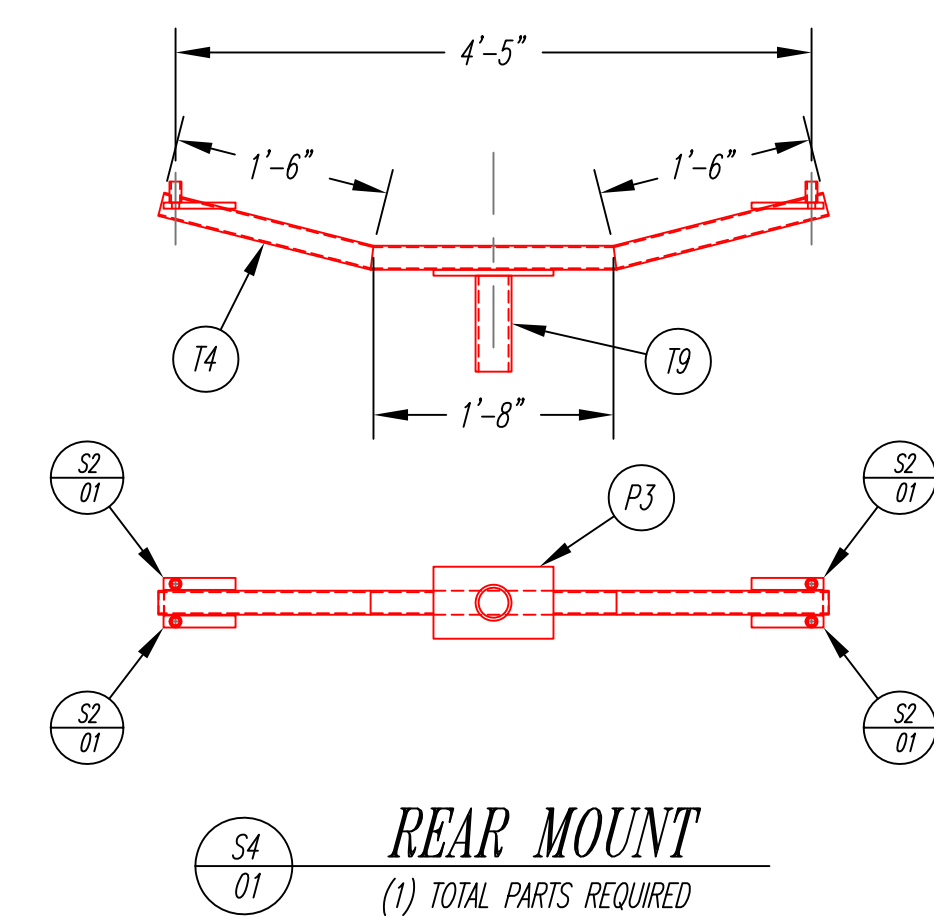


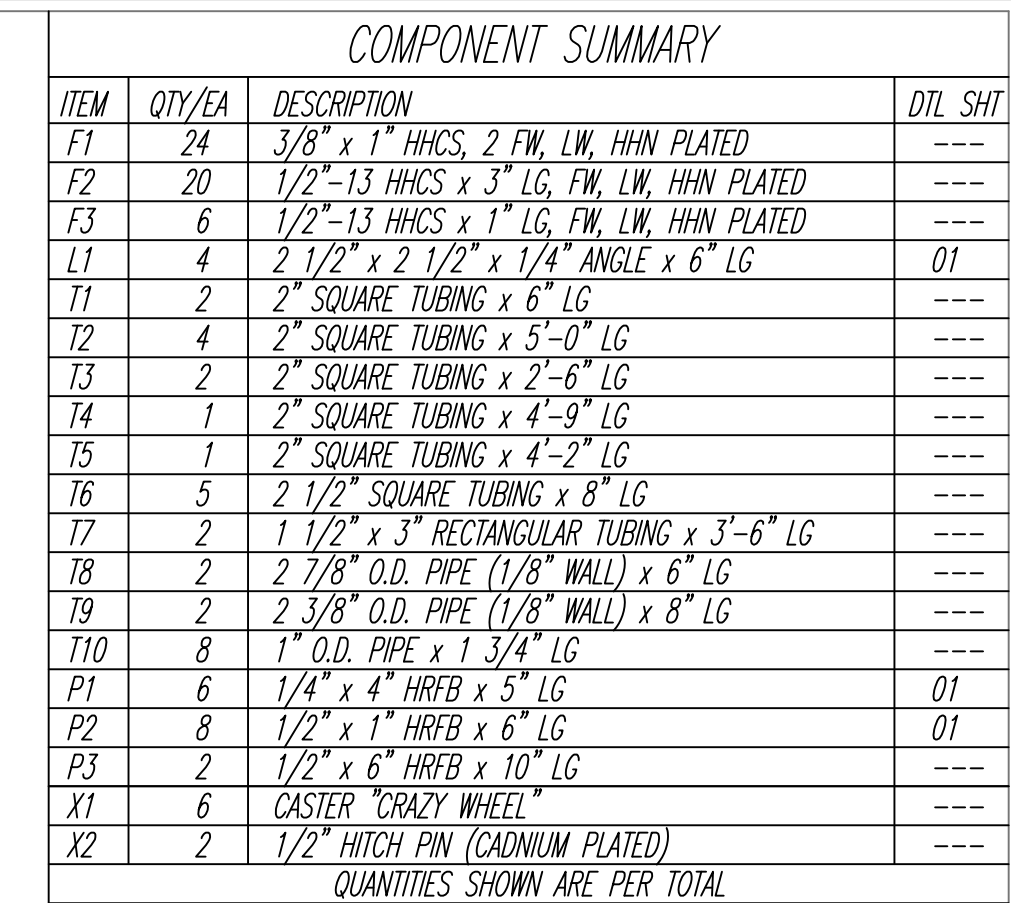

REV	DATE	DESCRIPTION OF CHANGES
A	02-12-07	UPDATE PER AS-BUILT

	J & D RACING ENGINEERING		TITLE PORSCHE 914 ROTISSERIE	
	SHEET SIZE D	COMPANY J & D RACING	SHOP DRAWING	
FILE NAME ROTISSERIE.DWG		PLOT SCALE 1 = 16	SCALE 3/4" = 1'-0"	DATE 02-12-07
REVISION .		JOHN BY JOHN FLESSBURG	DRAWING NO. 00-0009	SHEET # 1
		914-ROTISSERIE-01		